

Form 177

DEPARTMENTAL COMMUNICATION

To Mr. T. Noffsinger Dept. Engineering Date 1-26 1943

Re: GPW-16892 Catch assy Hood


Please add the note (Pack Spring with M-4601-A Grease or Equal. at assy.) omitted on the above drawing when released.

Make this change as soon as possible as suppliers are sending these in to us without the Grease and we have to improvise means of lubricating after assy. and this is expensive.

JAN 26 1943

J.L. McCloud
Chem. & Met. Lab.

JR/RE

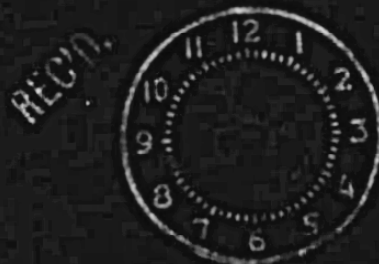

N-501


Signed _____ Dept. _____

ENGINEERING

SURFACES
CHES.

DRWG. STARTED		11-6-41	
DRWG. COMPLETED			
ENG. INF.	SUPP.	REVISED	CK.
L10	501	11-14-41	RF
L10	603	1-12-42	

MFG. DPT.	0
M	
B	
BD	
LIN	
DAG	
BEL	
FRA	
GER	
HOL	
SPN	
RUM	
ARG	
DEN	
CORK	
MEX	
BRA	
JAP	
AUST	
SWED	
LIN	

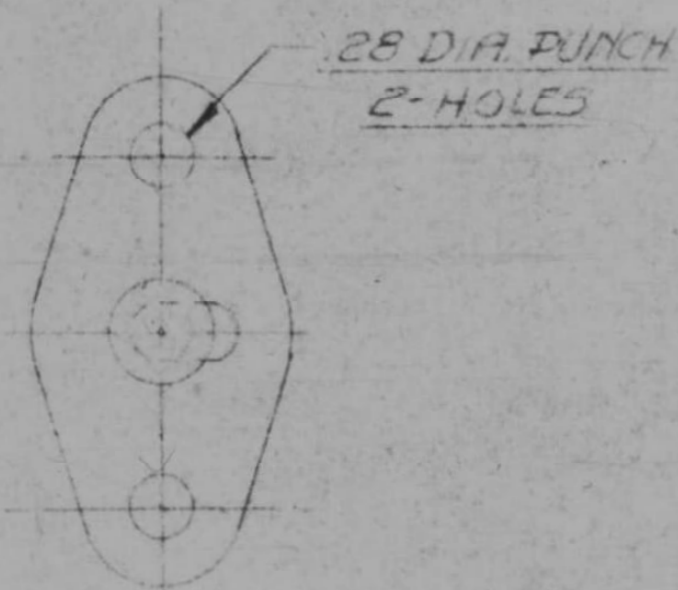

CATCH ASSY - HOOD
SAMPLE TO BE APPROVED BY ENG. DEPT.
FINISH - SEE PAINT SPEC.

DESIGN	SCALE	DRAWN BY	CK.	O.K.	FORD MOTOR CO.	GPW 16892
	FILL	W. L. E.		15	DEARBORN, MICH.	

MATERIAL AND NAME